

# ROBBY'S REEF

16 Nautical Miles from Carrabelle, FL

## NORTHWEST

LAT: 29°39.613'

LONG: 84°30.016'




"CRABTOR"

## NORTHEAST

LAT: 29°39.614'

LONG: 84°29.985'

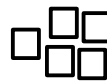

Grouper Boxes (5)

## SOUTHWEST

LAT: 29°39.600'

LONG: 84°30.016'



Limestone Specials (5)

## CENTER

LAT: 29°39.600'

LONG: 84°30.000'



Florida Specials (5)

LAT: 29°39.597'  
LONG: 84°29.968'

Wayward Culverts


## SOUTHEAST

LAT: 29°39.587'

LONG: 84°29.984'



Concrete Culverts

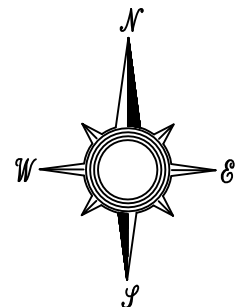

8/24/2011